




EXISTING PROPOSED BUILDING AND PLAYGROUND
SCALE: 1"=10'

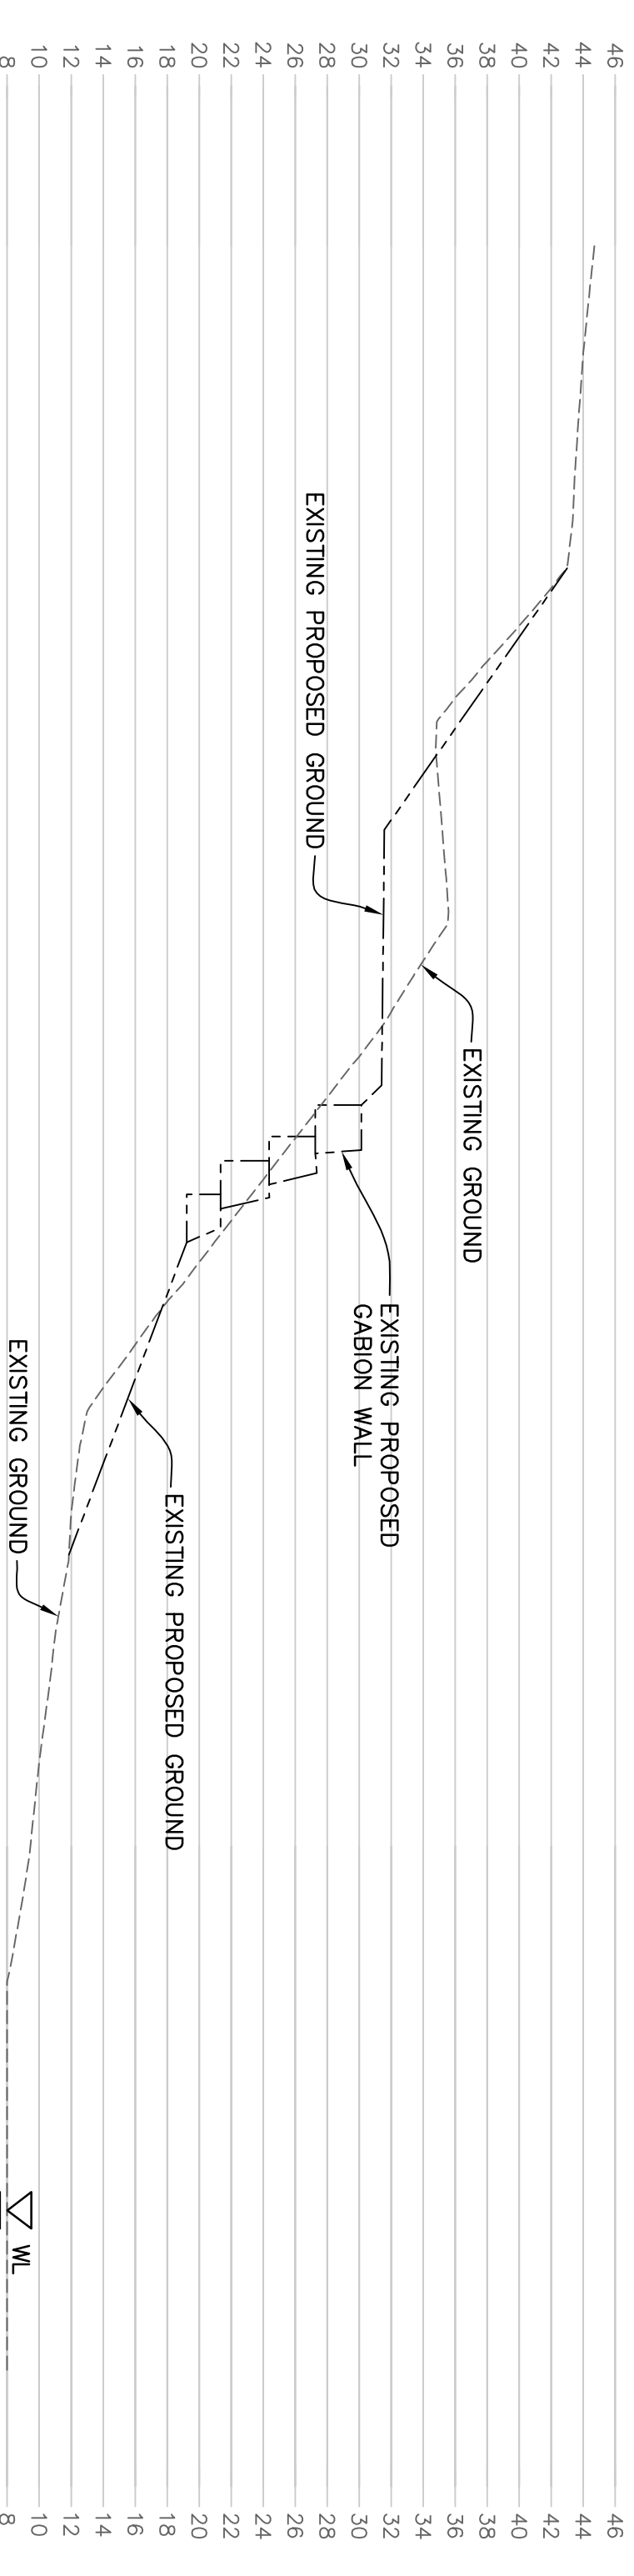


EXISTING PROPOSED GABION WALL
SCALE: 1"=10'

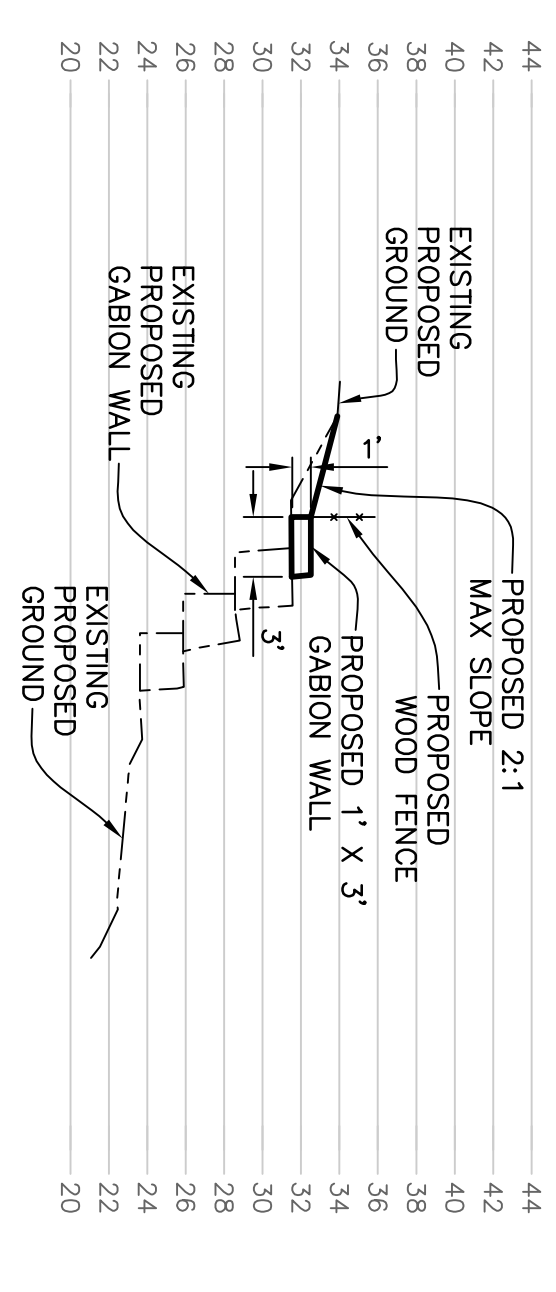

PROPOSED GABION WALL
SCALE: 1"=10'

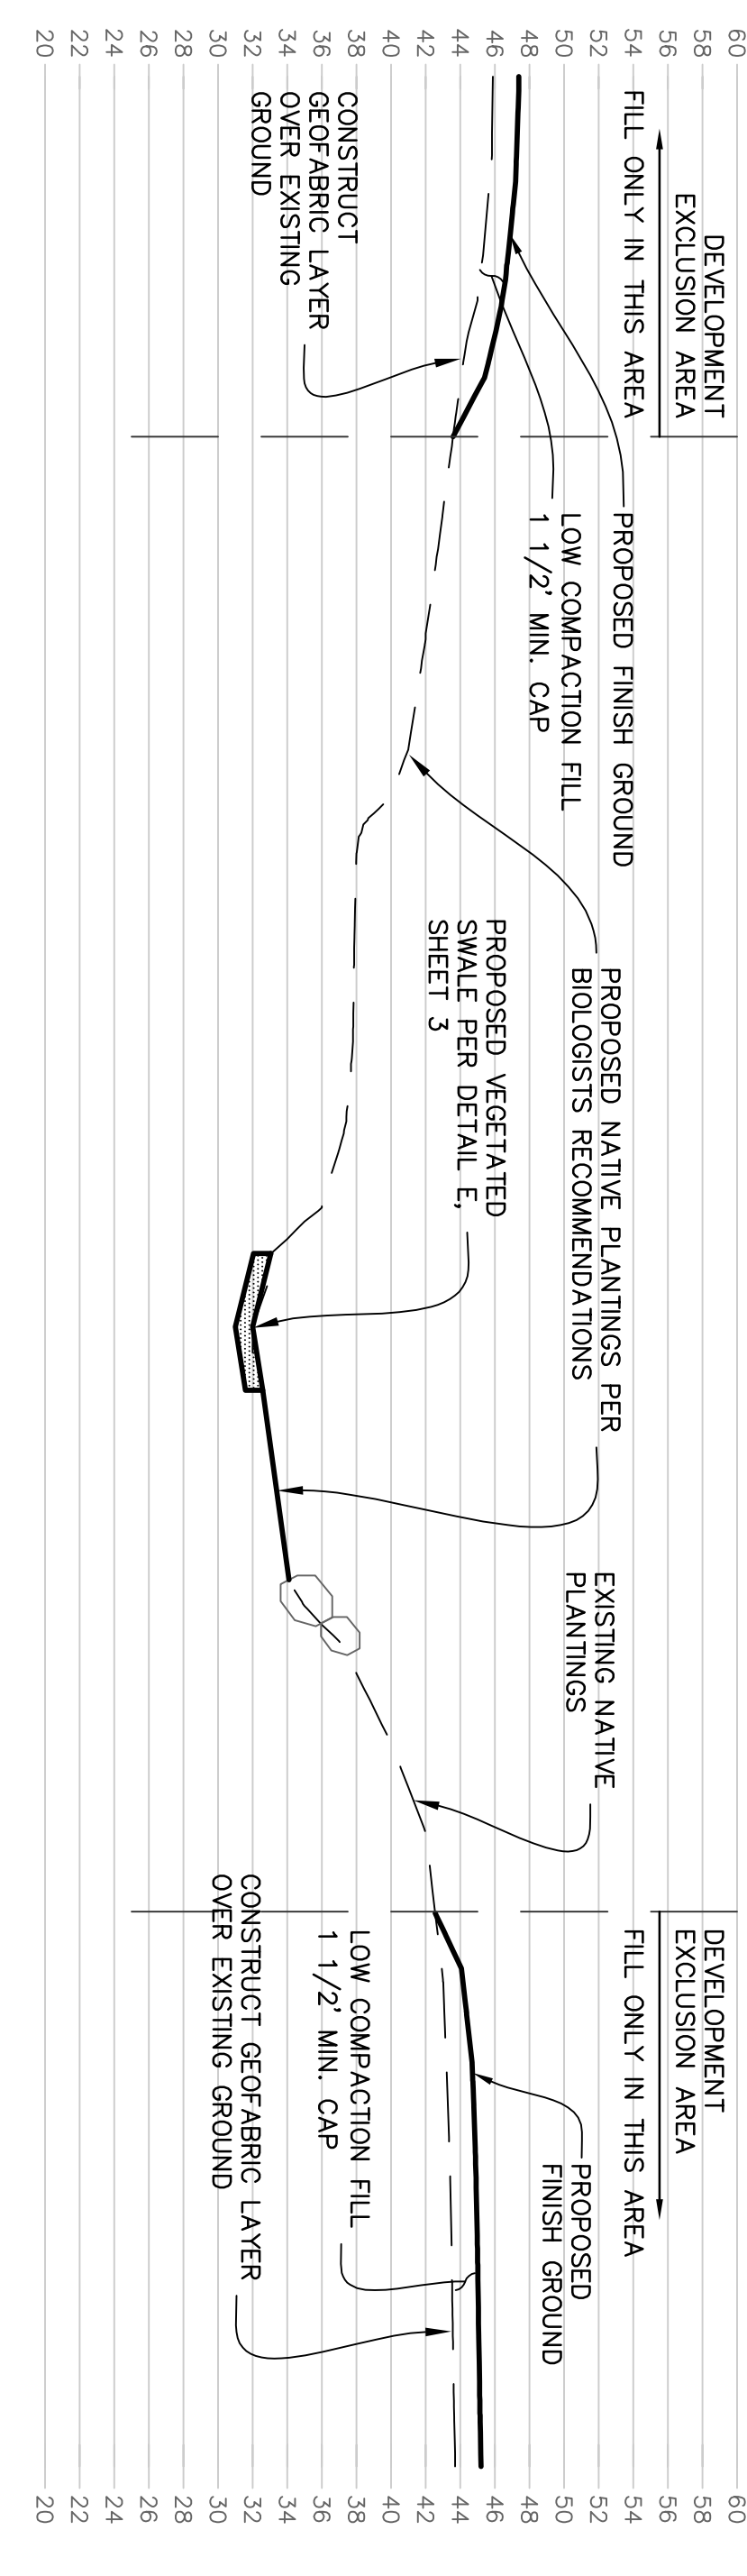


PROPOSED RESOURCE CAPPING AND VEGETATED SWALE
SCALE: 1"=10'

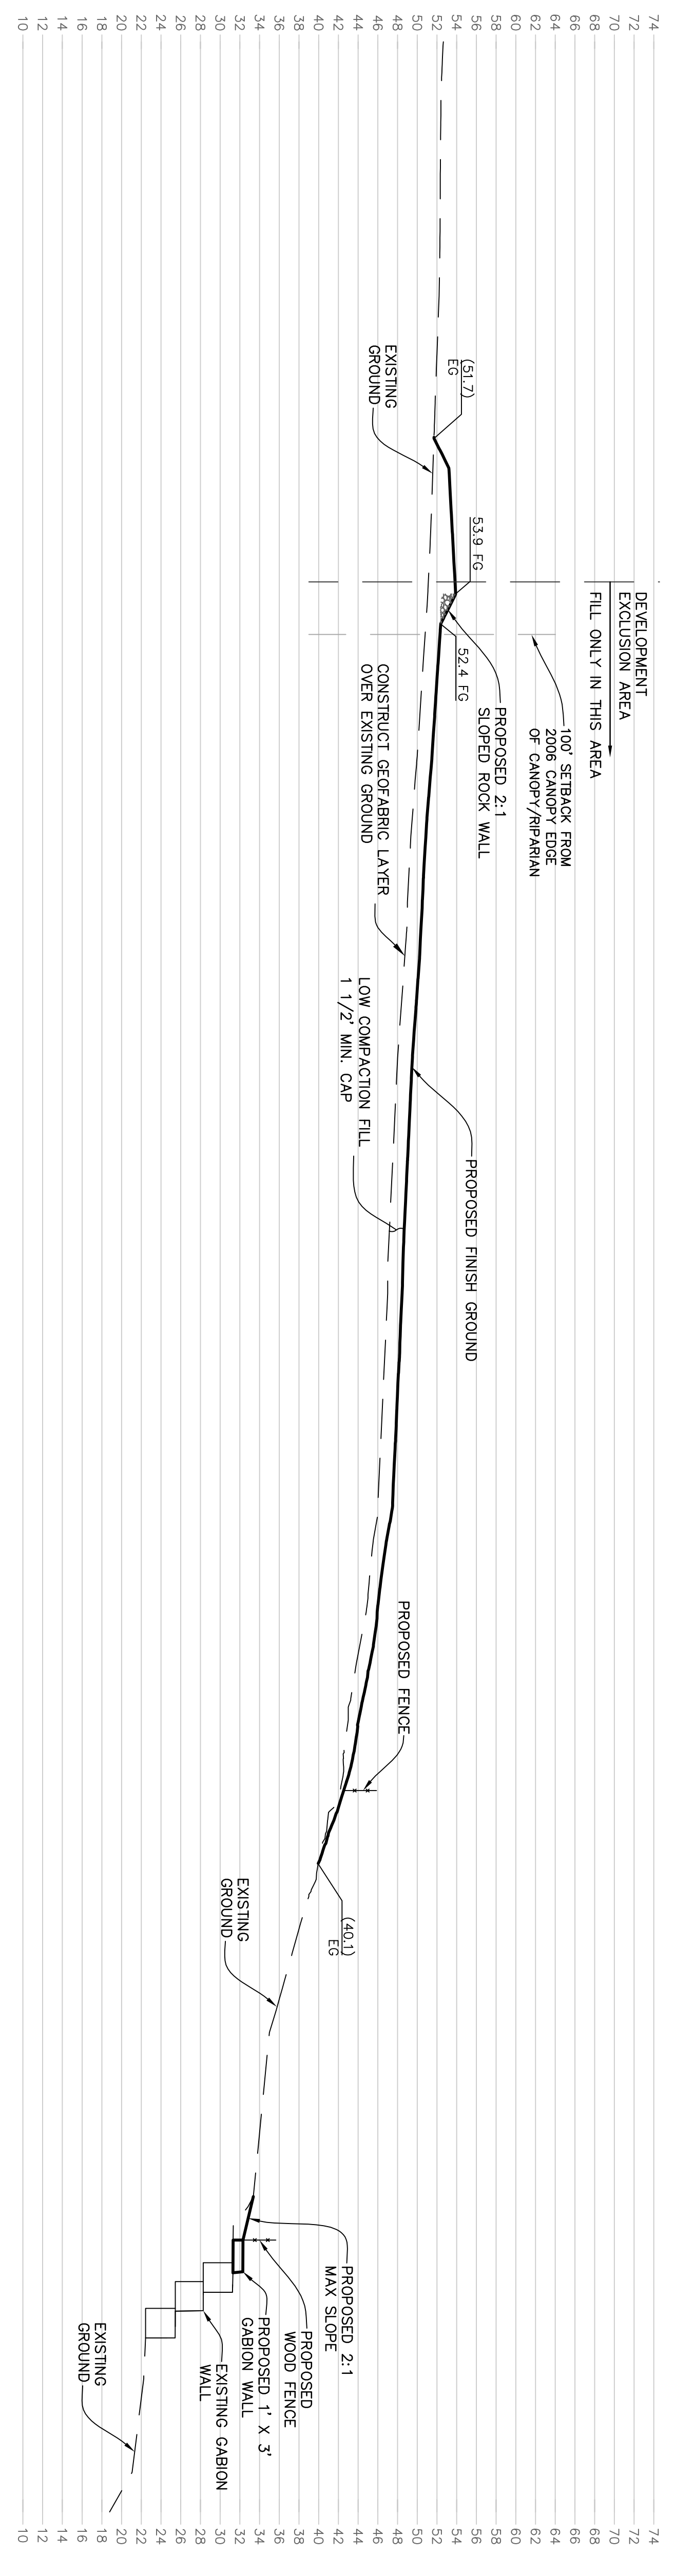


PROPOSED RESOURCE CAPPING GRADING
SCALE: 1"=10'




GABION WALL
REVEGETATION AREA
NOTE: SEE RESTORATION DETAILS BY LAWRENCE HUNT.

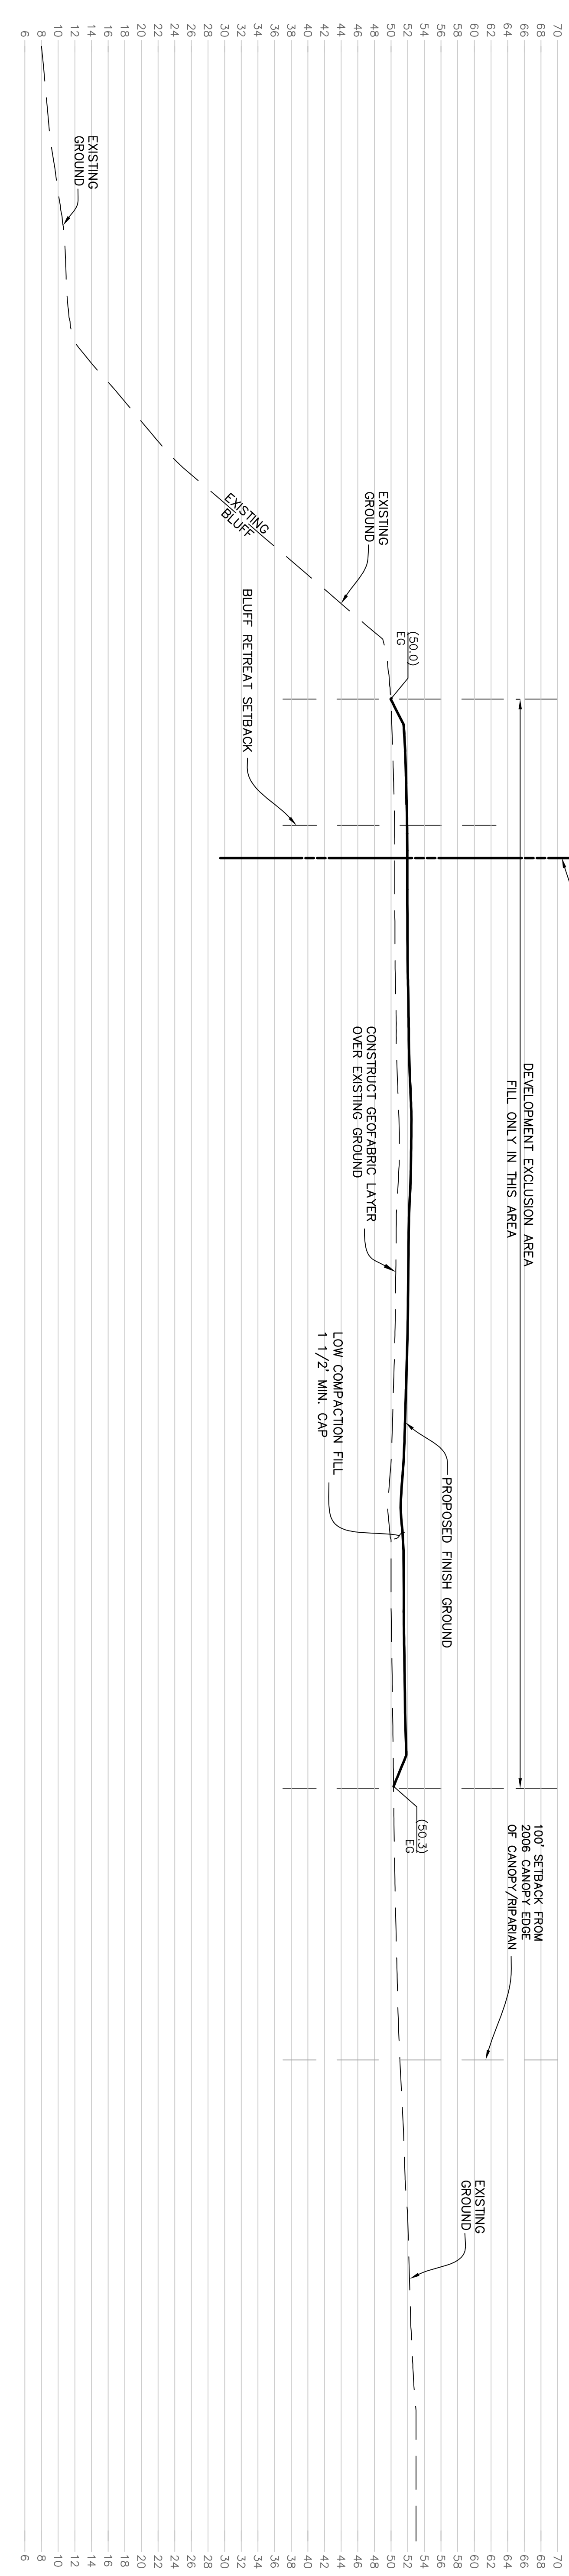

PROPOSED RESOURCE CAPPING GRADING
SCALE: 1"=10'

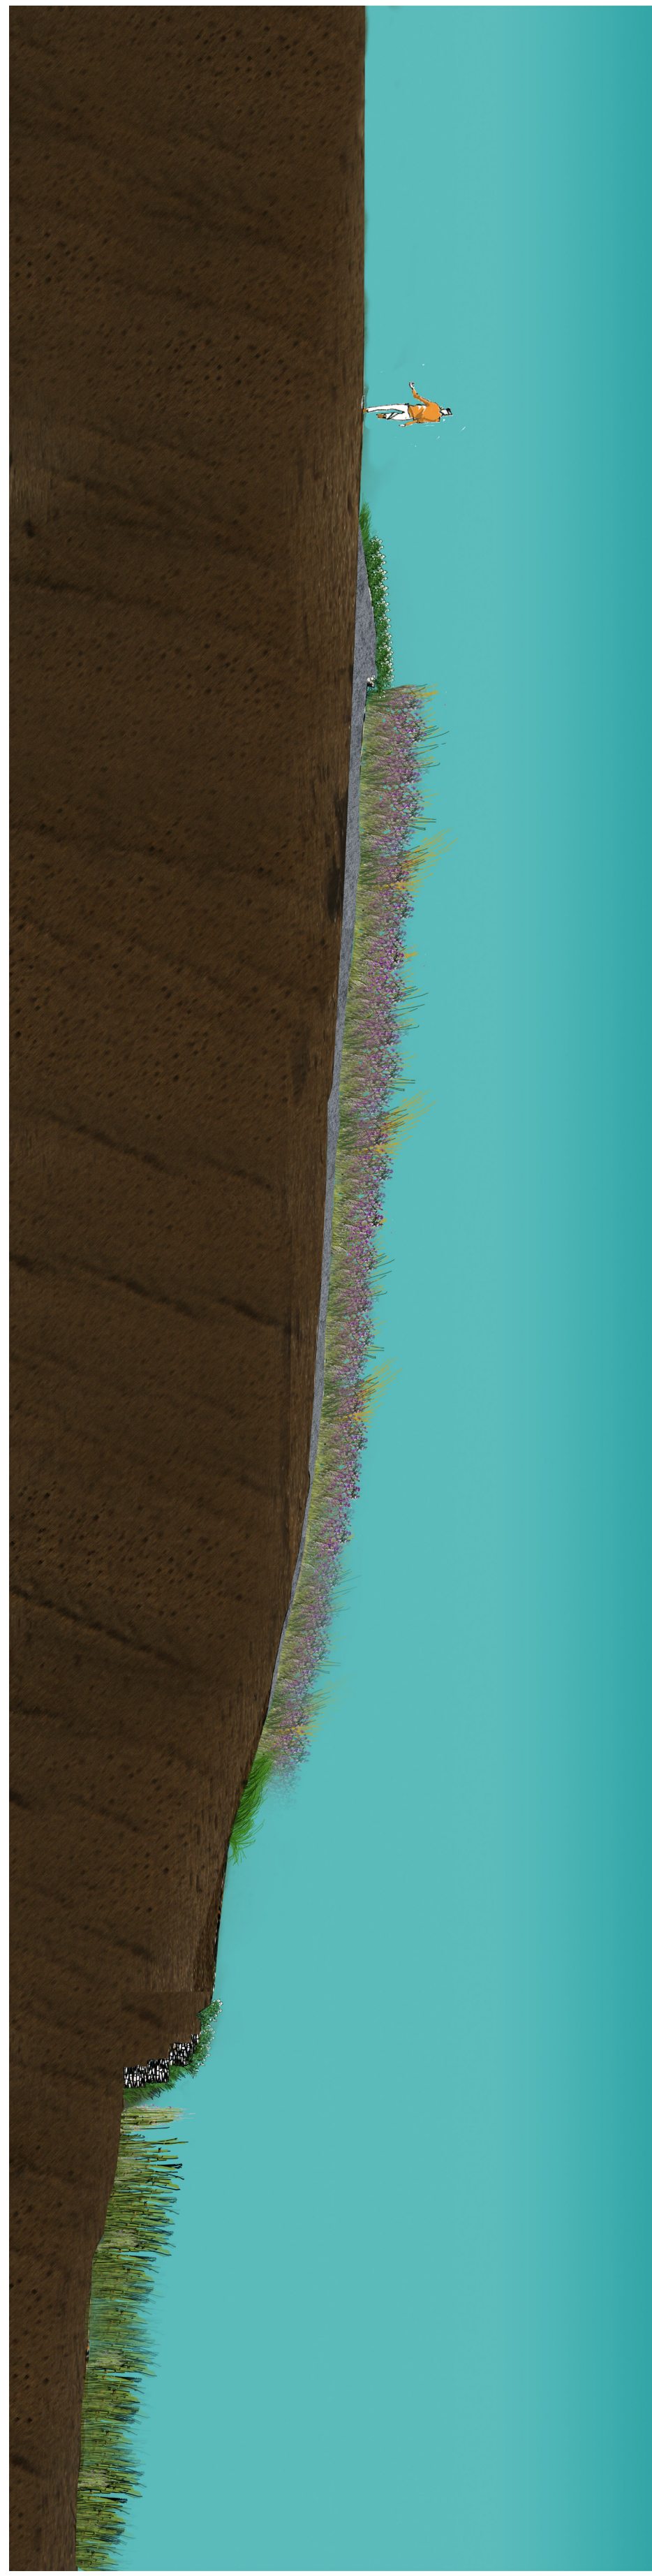

CROSS SECTION D - ARCHITECT'S RENDITION
SCALE: N.T.S.

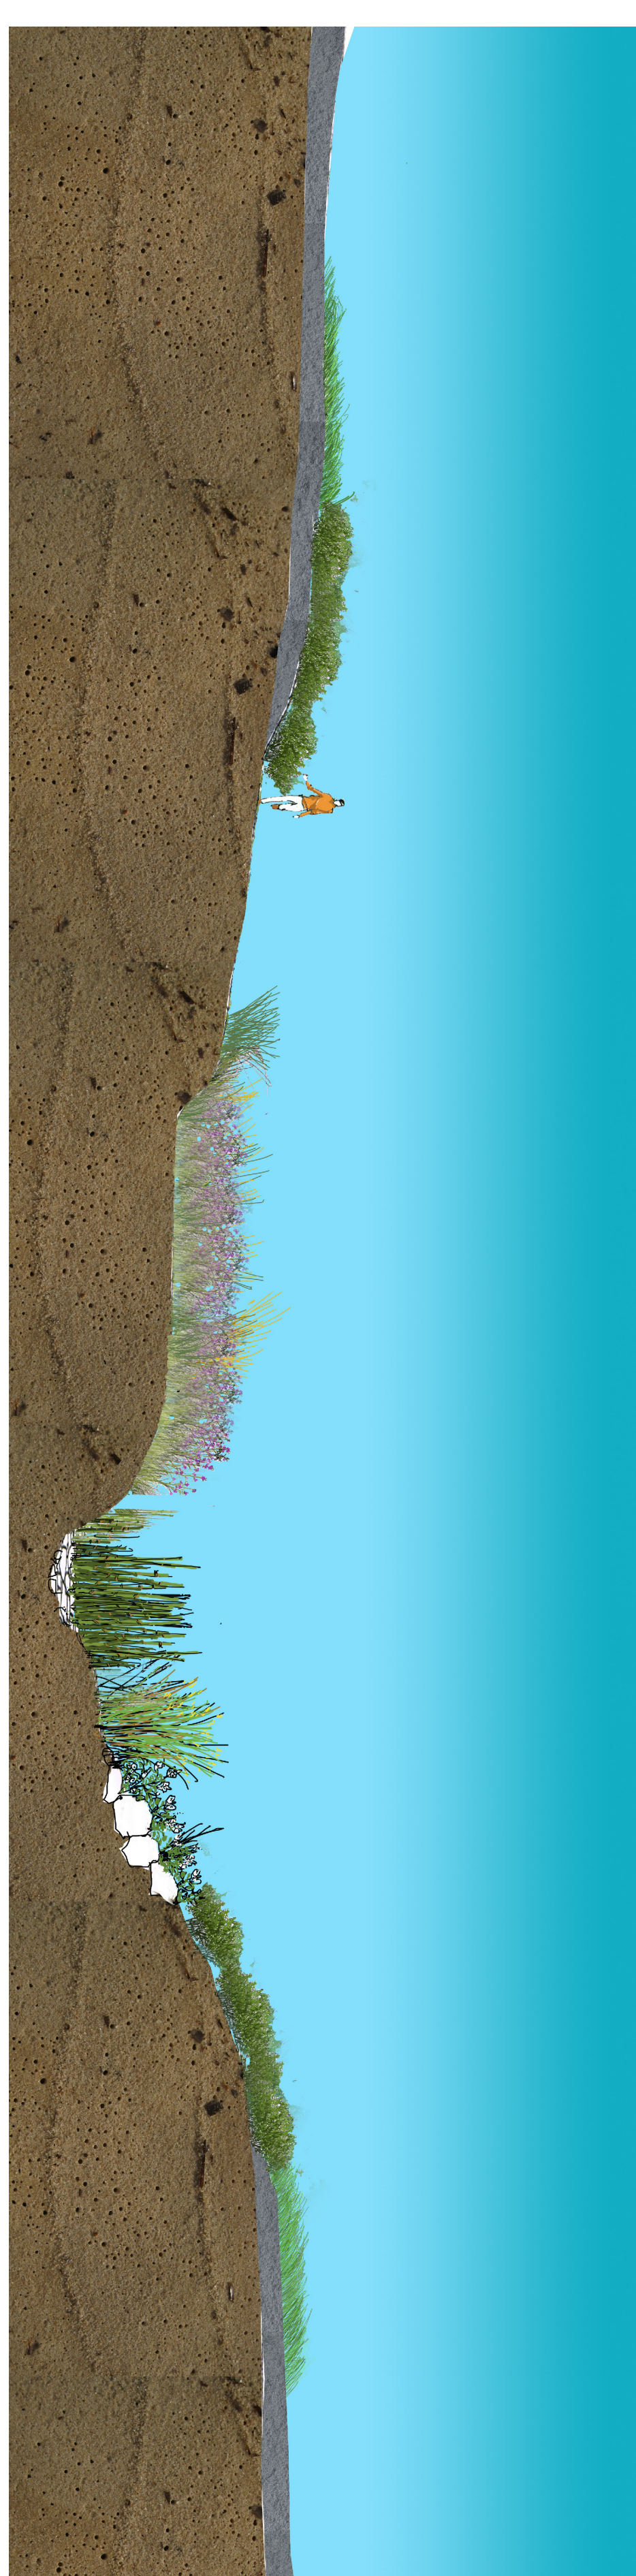

CROSS SECTION F - ARCHITECT'S RENDITION
SCALE: N.T.S.

NOTE

HABITAT RESTORATION AND VEGETATION PER HUNT AND ASSOCIATES BIOLOGICAL CONSULTING SERVICES, PREVIOUSLY APPROVED UNDER PERMIT NO. 17189-03.

NO.	DATE	REVISIONS

<p>Perfield & Smith 111 East Linden Street San Diego, CA 92101 Phone: (602) 943-2332</p>	<p>DESIGN: JBU CHECKED: JEN</p>	<p>CROSS SECTIONS AND PICTURES 110DH-00000-00006 AS-BUILT GRADING AND MODIFICATIONS TO THE HABITAT RESTORATION AND VEGETATION PLAN 2823 PAVED LAKE SUMMERLAND, SANTA BARBARA COUNTY, CA</p>
	<p>PROJECT ENGINEER KATE E. ANDERSON R.C.C. 20811</p>	