

COUNTY OF SANTA BARBARA
STATE OF CALIFORNIA
DEPARTMENT OF PUBLIC WORKS

PLANS FOR THE CONSTRUCTION OF


**RECTANGULAR RAPID FLASHING BEACONS
ISLA VISTA, MONTECITO, AND SUMMERLAND
STATE-AID PROJECT NO. HSIPSL-5951(183)
1ST AND 2ND SUPERVISORIAL DISTRICTS**

APPROVED - CHAIRMAN, BOARD OF SUPERVISORS
DocuSigned by:
Scott McGowan
APPROVED - CHIEF OF PUBLIC WORKS

DocuSigned by:
Mustafa Estai
APPROVAL RECOMMENDED - ENGINEERING SECTION MANAGER
02/28/2023

INDEX TO SHEETS

SHEET	DESCRIPTION
1	TITLE SHEET
2	ISLA VISTA LAYOUT
3	MONTECITO LAYOUT
4	SUMMERLAND LAYOUT

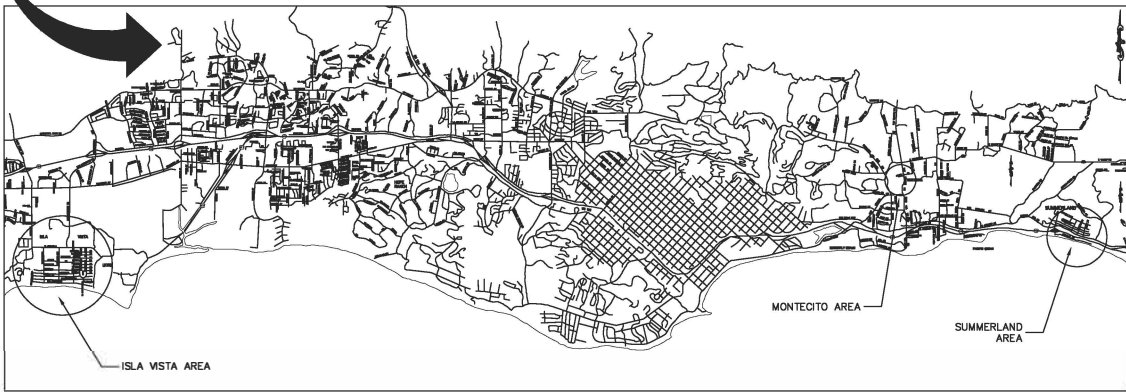

VICINITY MAP

NO SCALE



NOTE:
IT SHALL BE THE RESPONSIBILITY OF THE CONTRACTOR TO WORK WITH THE LOCAL UTILITY COMPANIES TO LOCATE ALL UNDERGROUND UTILITY SERVICE LINES WITHIN THE PROJECT LIMITS. CALL UNDERGROUND SERVICE ALERT AT (800) 422-4133 OR 811 A MINIMUM OF TWO WORKING DAYS PRIOR TO ANY EXCAVATION WORK.

TITLE SHEET
TS

CONSTRUCTION STARTED:	DESIGNED BY: H. LAZARO	CHECKED BY: G. SMART	SCALE: NTS	PROJECT NO. 820796	RECTANGULAR RAPID FLASHING BEACONS	SHEET NO. 1 OF 4
CONSTRUCTION COMPLETED:	DRAWN BY: H. LAZARO	CONSTRUCTIBILITY REVIEW BY: A. ESTRADA				FILE NO.
RECORD DRAWING APPROVED BY: <i>Mustafa Estai</i>	DATE: 11/30/2023	DATE: 11/30/2023				
SURVEY CHECKED BY:	FOR REDUCED PLANS ORIGINAL SCALE IN INCHES 0 1 2 3		DISREGARD PRINTS BEARING EARLIER REVISION DATES		REVISION DATES (FOR PRELIMINARY STAGE ONLY)	

COUNTY OF SANTA BARBARA
 DEPARTMENT OF PUBLIC WORKS
 TRANSPORTATION DIVISION
RECTANGULAR RAPID FLASHING BEACONS